

What changed, and why these drawings are different

The earlier allocation drawing packed room rectangles into columns and said so, because wall centrelines could not be recovered from the as-built PDFs. That was wrong about the PDFs. They are vector exports from CAD, not scans, and the exporter used a separate pen width for wall faces, for door swings and window symbols, and for dimension lines. Every wall, every door and every swing on these sheets is the surveyed position, recovered to about 10 mm against the dimension chains. Rooms are flood filled between the real walls, so the areas are measured rather than assumed.

Corrections to the architectural brief

ITEM	BRIEF SAID	SURVEY SAYS	WHY IT MATTERS
Overall footprint	24,695 x 13,025 mm	24,695 x 16,317 mm	The brief understated the depth. The building is deeper on the west than on the east, 13,527 mm against 12,346 mm, and the two blocks are offset.
Theatre room	24.7 sqm, from 5,729 x 4,306	32.8 sqm measured	The as-built dimension is 6,306 deep, not 4,306. The theatre is a third larger than assumed and comfortably takes a day case suite.
Recovery	13.0 sqm in the Dining, across the plan	19.2 sqm directly adjoining the theatre	The Dining is open to the reception hall and is nowhere near the theatre. The east bedroom shares a wall with it, so the suite closes properly.
Reception and waiting	58.1 sqm	69.6 sqm measured	The Living Room and Dining are one open space with no wall between them.
First floor consulting	Three rooms of about 17 sqm each	Three of about 13 sqm, or two of 18	The room measures 41.8 sqm net, not 51.6. Three 17 sqm rooms plus a corridor needs space that is not there.

Measured areas

GROUND FLOOR			FIRST FLOOR		
Theatre	4 rooms	63.9 sqm	Clinic	7 rooms	111.7 sqm
Clinic	1 rooms	20.3 sqm	Procedure	2 rooms	41.5 sqm
Diagnostics	3 rooms	38.3 sqm	Diagnostics	2 rooms	23.4 sqm
Pharmacy	1 rooms	5.2 sqm	Common	11 rooms	97.5 sqm
Common	8 rooms	142.1 sqm	Boh	1 rooms	8.9 sqm
Boh	2 rooms	12.2 sqm			
Net internal		282.2 sqm	Net internal		283.0 sqm

Sheets

- 1 Drawing set, corrections and measured areas
- 2 Ground floor, target operating state
- 3 First floor, target operating state
- 4 Ground floor, access and flow
- 5 First floor, access and flow
- 6 Ground floor, demolition and new work
- 7 First floor, demolition and new work

Not drawn here

The guest chalet and the boys' quarters have no as-built drawing in the pack, so they are not on these sheets. Their allocation stays in lyfeplace-abuja-allocation.pdf, which remains a schedule rather than a plan. Ask the vendor for those two survey drawings and they can be drawn the same way in an afternoon. Site levels, the car park, the external waste holding area and the ambulance standing are also outside this set: they need a site plan, which the pack does not contain.



ZONES

THEATRE

CLINIC

DIAGNOSTICS

PHARMACY

COMMON

BOH

Day case theatre suite, sole use

Consulting, private medical plaza

Diagnostics and imaging

Pharmacy, patient facing

Arrival, circulation, WC

Back of house

Red walls are new. Red door symbols are new openings. Everything in black is surveyed.

ROOM SCHEDULE, MEASURED		
USE	WAS	SQM
RECEPTION, WAITING AND CONCIERGE	Living Room Dining	69.6
CIRCULATION SPINE	Lobby	35.6
DAY CASE THEATRE	Bedroom	32.8
CONSULTING 1	Bedroom	20.3
MONITORED RECOVERY, 2 BAYS	Bedroom	19.2
DIGITAL X-RAY, LEAD SHIELDED	Bedroom	18.7
PHLEBOTOMY AND SPECIMEN HANDLING	Kitchen	16.9
STAIRCASE	new	13.3
STAFF CIRCULATION	Cor.	9.7
ENTRANCE VESTIBULE	new	7.3
DIRTY UTILITY	Bath.	6.9
CLEAN UTILITY AND CONSUMABLES	new	6.3
STAFF CHANGE AND WC	Bath.	5.9
MEDICATION COLLECTION POINT	Store	5.2
SCRUB AND STERILE STORE	Bath.	5.1
ENTRANCE PORCH	new	3.1
X-RAY CHANGING AND CONTROL	Bath.	2.7
CIRCULATION	new	1.9
CIRCULATION	new	1.7
NET INTERNAL, THIS FLOOR		282.2





CLINIC

PROCEDURE

DIAGNOSTICS

COMMON

BOH


Consulting, private medical plaza
Procedure and treatment
Diagnostics and imaging
Arrival, circulation, WC
Back of house

Red walls are new. Red door symbols are new openings. Everything in black is surveyed.

ROOM SCHEDULE, MEASURED

USE	WAS	SQM
DOCTORS' AND MEMBERS' LOUNGE	Living Room	32.9
FUE HAIR TRANSPLANT SUITE	Kitchen	26.1
CONSULTING 3	Bedroom	21.1
CONSULTING 2	Bedroom	20.8
ULTRASOUND AND ECHOCARDIOGRAPHY	Bedroom	18.9
CONSULTING 7	new Playroom	18.1 15.4
TREATMENT ROOM	Bedroom	15.0
CONSULTING 8	new	13.4
STERILISING AND CLEAN UTILITY	new	13.3
STAIRCASE	new	13.0
CONSULTING 5	Living Room	12.5
CONSULTING 6	new	11.3
CONSULTING 4	new	8.9
LINEN AND CONSUMABLES	Store	8.5
PATIENT WC, ACCESSIBLE	Bath.	6.5
STAFF WC	Bath.	6.2
TERRACE	Balco.	5.0
PATIENT WC	Bath.	4.6
PHLEBOTOMY DRAW POINT	Bath.	4.3
CONSULTING CORRIDOR	new	2.8
CIRCULATION	new	2.3
STAIR LANDING	new	2.3
NET INTERNAL, THIS FLOOR		283.0



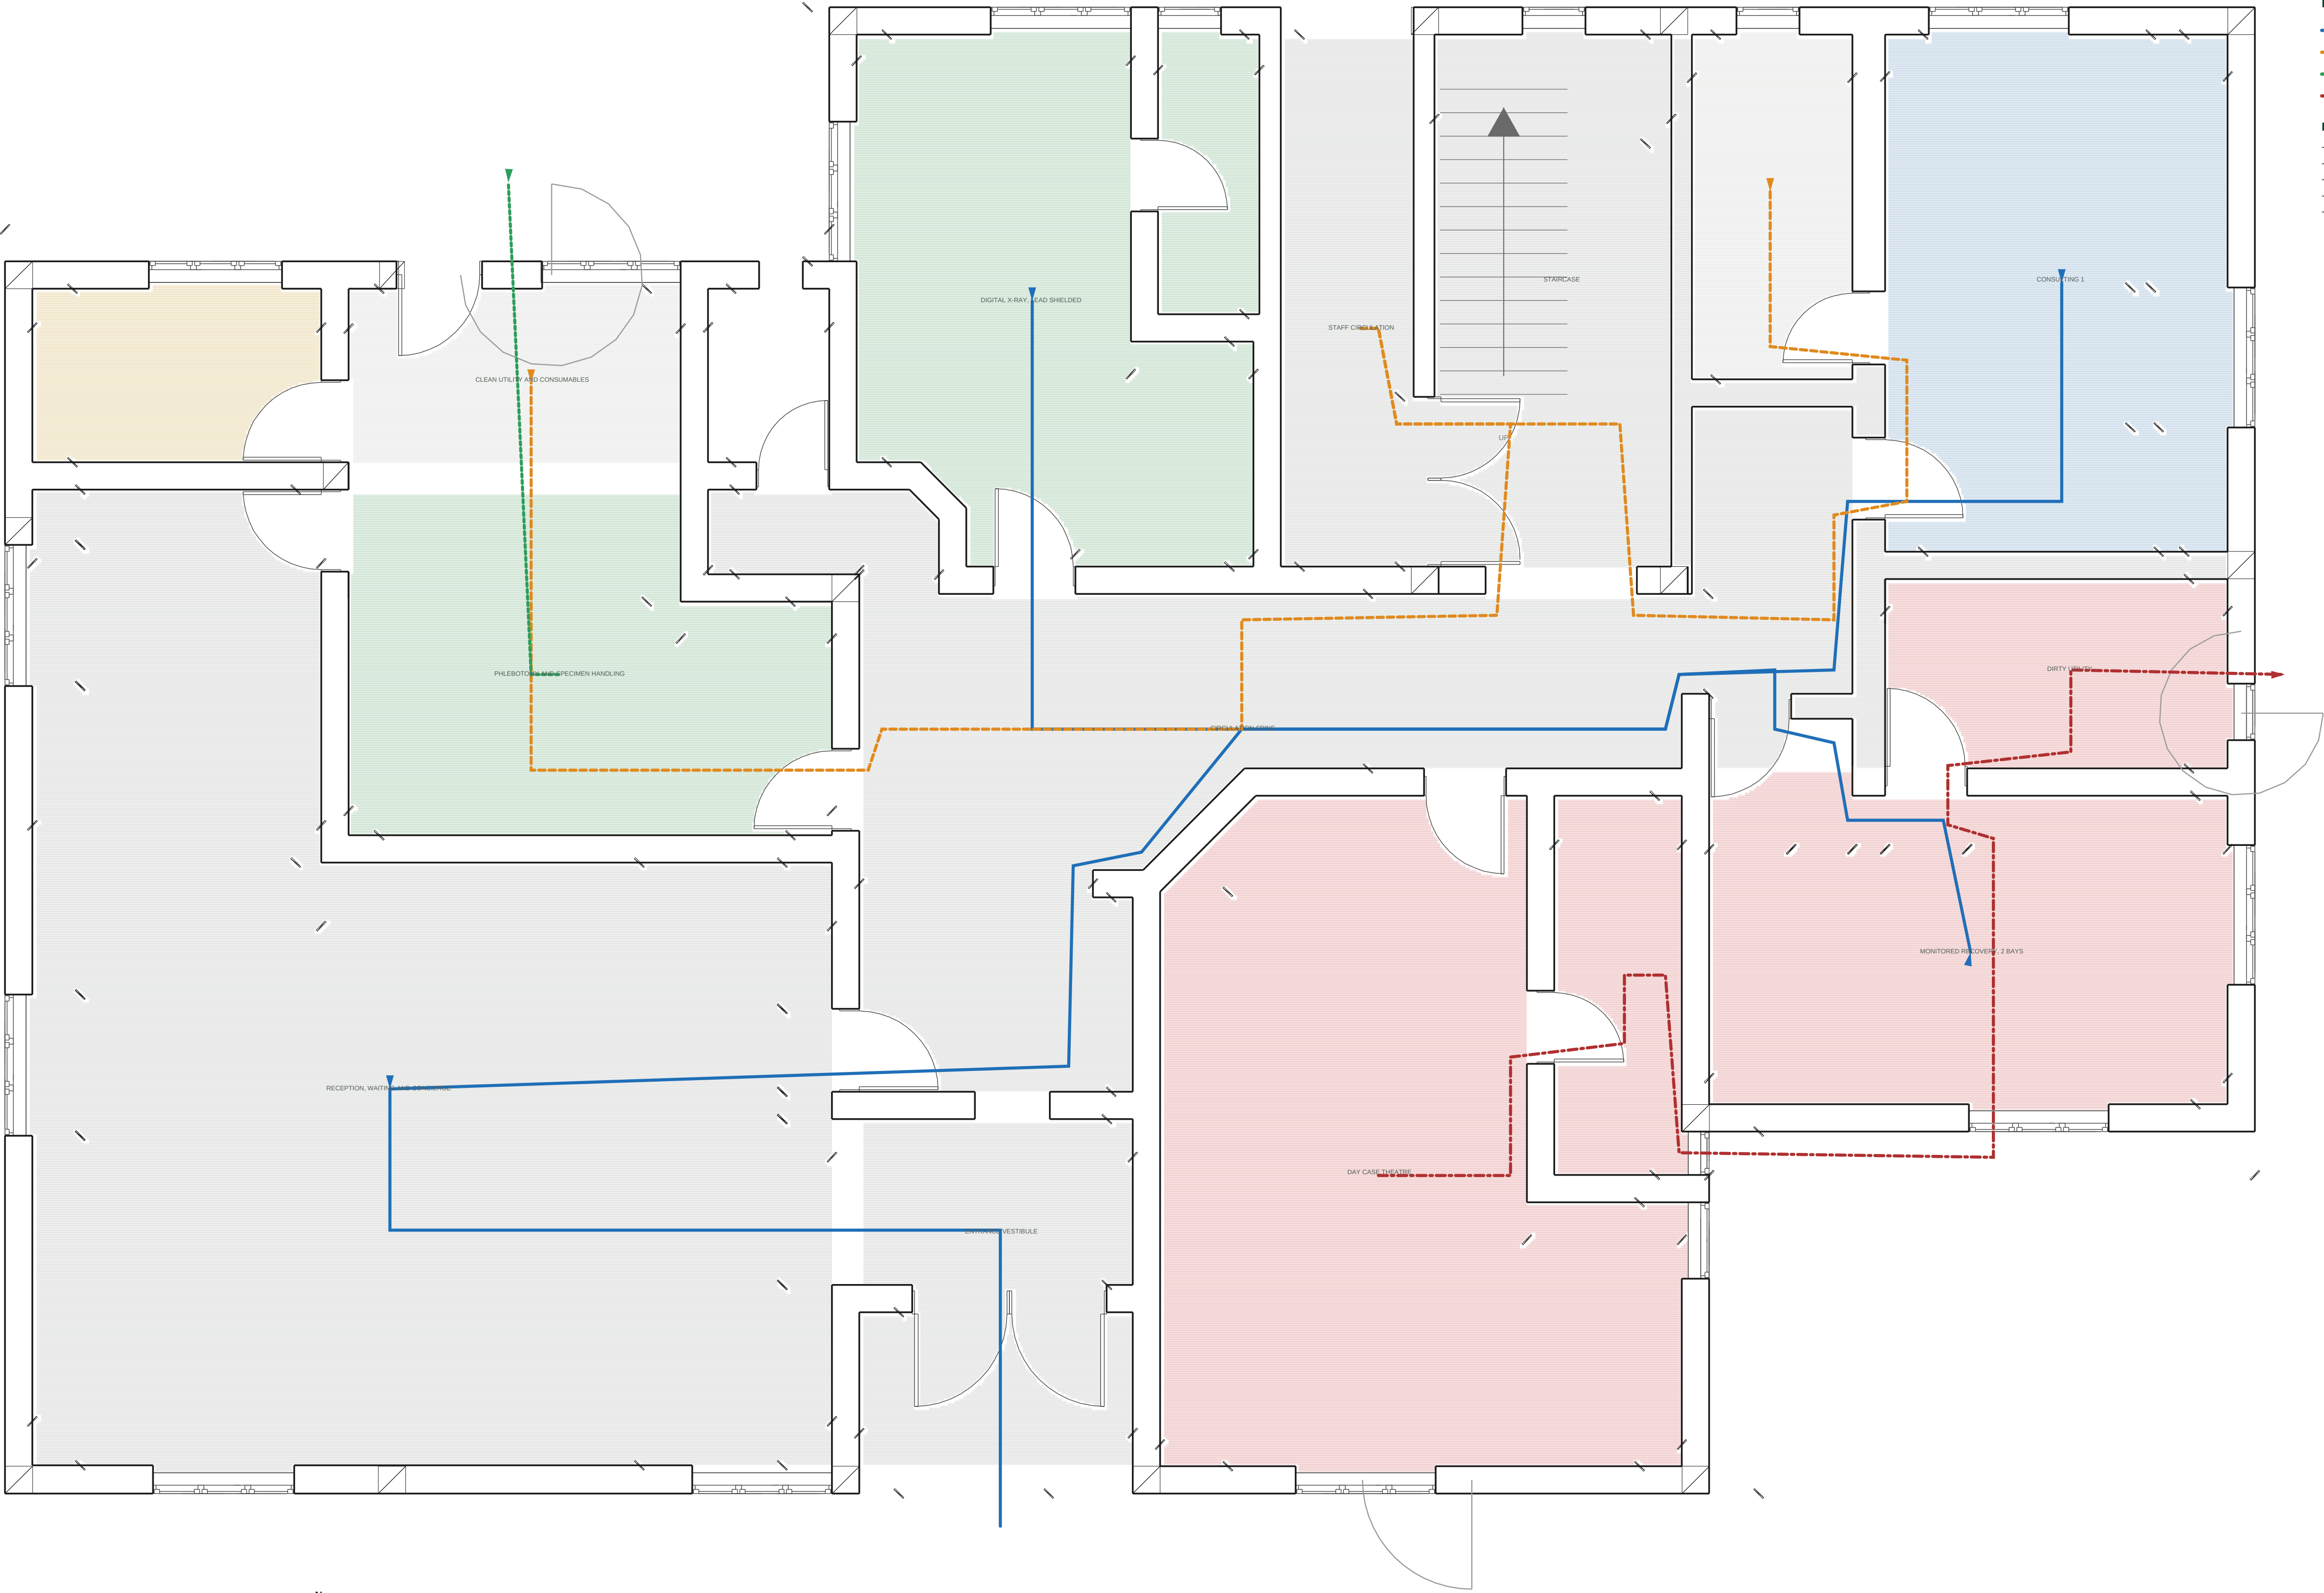

- ROUTES**
- PATIENT

arrival, waiting, consulting room, out

STAFF

back of house, never through the waiting hall

SPECIMEN

draw point to the chalet laboratory

WASTE

to the external holding area
- RULES THE DRAWING MUST KEEP**
- The specimen route must not cross the patient waiting hall.


The clinical waste route must not cross the patient or specimen routes.

Staff reach the lounge, sterilising and linen without passing through waiting.

One reception desk, one patient entrance. Do not draw a second.


The theatre suite has a single controlled entry off the spine. Nothing passes through it to reach anywhere else.



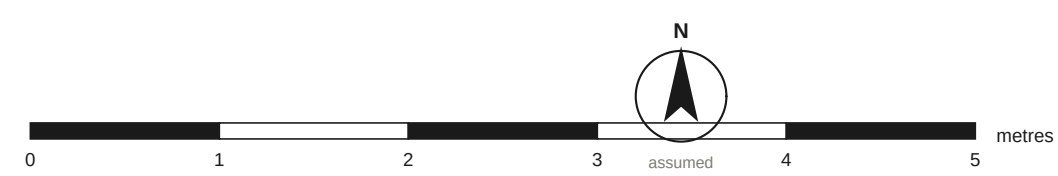

 PATIENT
 STAFF
 SPECIMEN
 WASTE

- ## **RULES THE DRAWING MUST KEEP**
- The specimen route must not cross the patient waiting hall.
 - The clinical waste route must not cross the patient or specimen routes.
 - Staff reach the lounge, sterilising and linen without passing through waiting.
 - One reception desk, one patient entrance. Do not draw a second.
 - The theatre suite has a single controlled entry off the spine. Nothing passes through it to reach anywhere else.

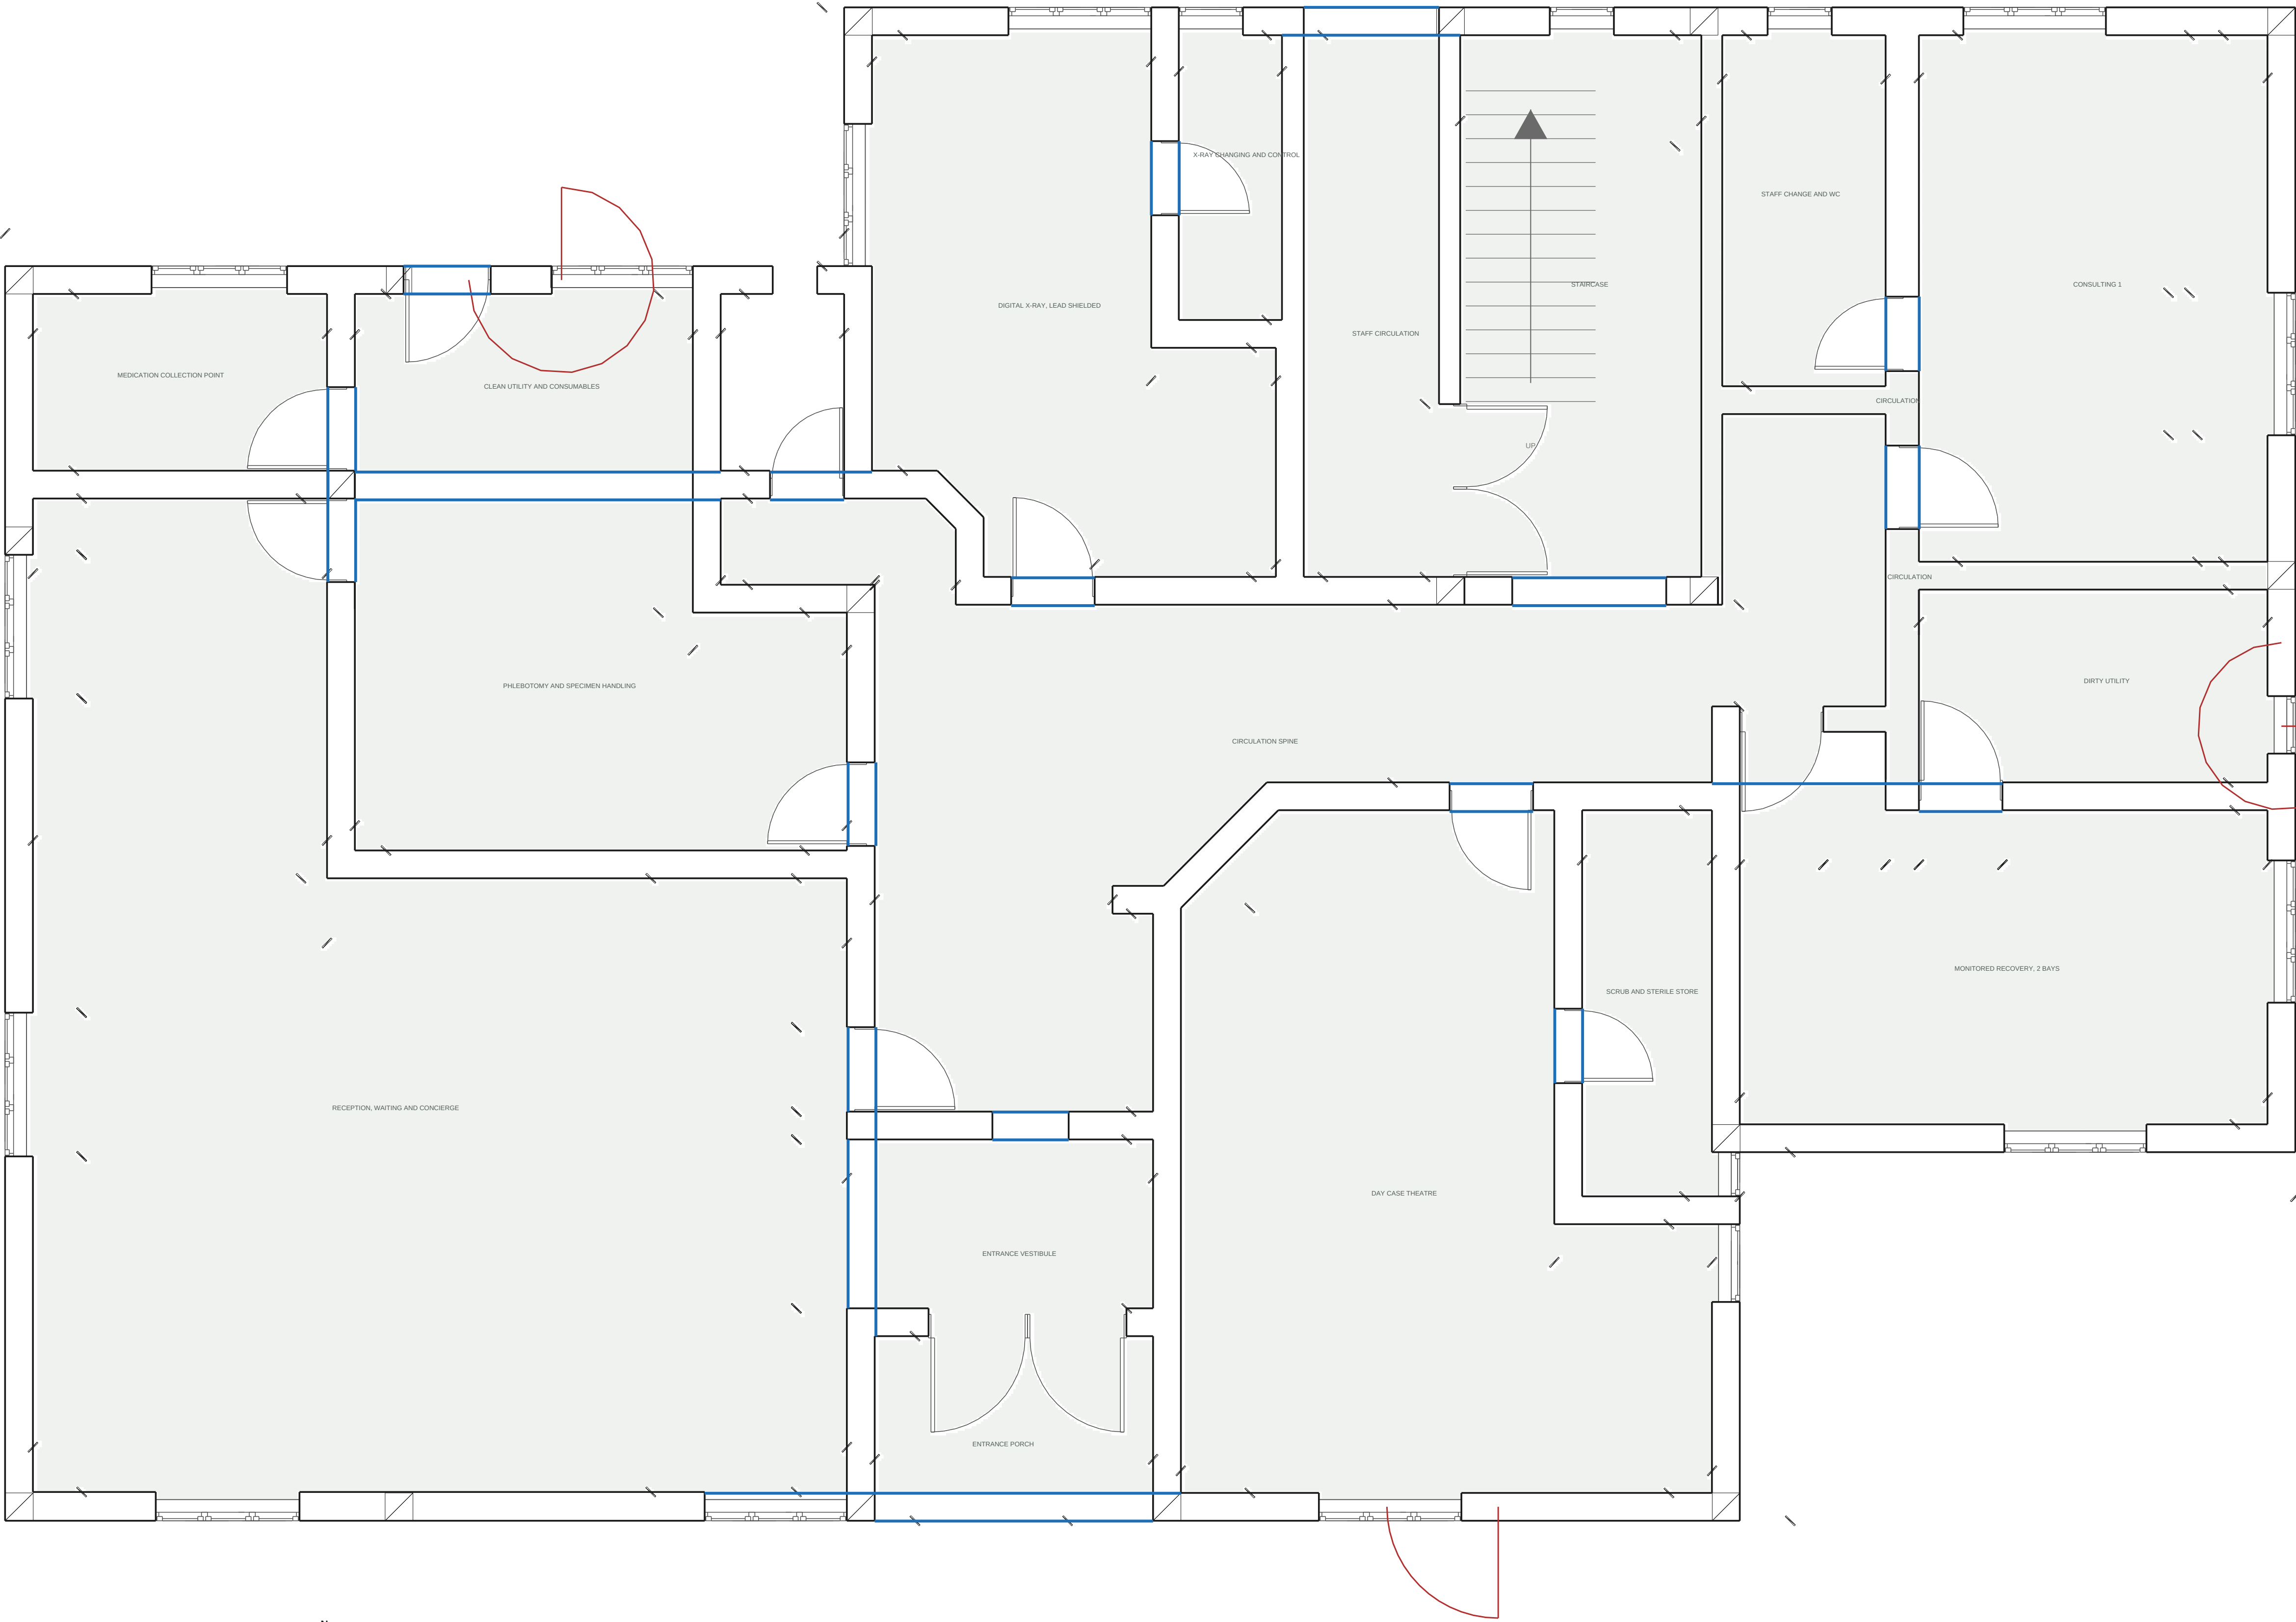


- KEY**
- Existing wall, retained
 - New partition
 - Existing cased opening, no door today
 - Existing door swing or window, surveyed position

COUNTS, THIS FLOOR

Existing door and window openings, surveyed	36
Existing cased openings with no door	36
New partitions	0
New internal door openings	0
New openings in external walls	3
Rooms in the target state	19

- No new partitions are needed on this floor. Every room in the target state is an existing room, which is why the ground floor can be fitted out first.
- The theatre suite is formed from four existing rooms that already adjoin: theatre, recovery, scrub and sterile store, dirty utility. Only the doors and the services change.
- The two waiting zones in the reception hall are divided by joinery, not a wall, so the single desk keeps sight of both.



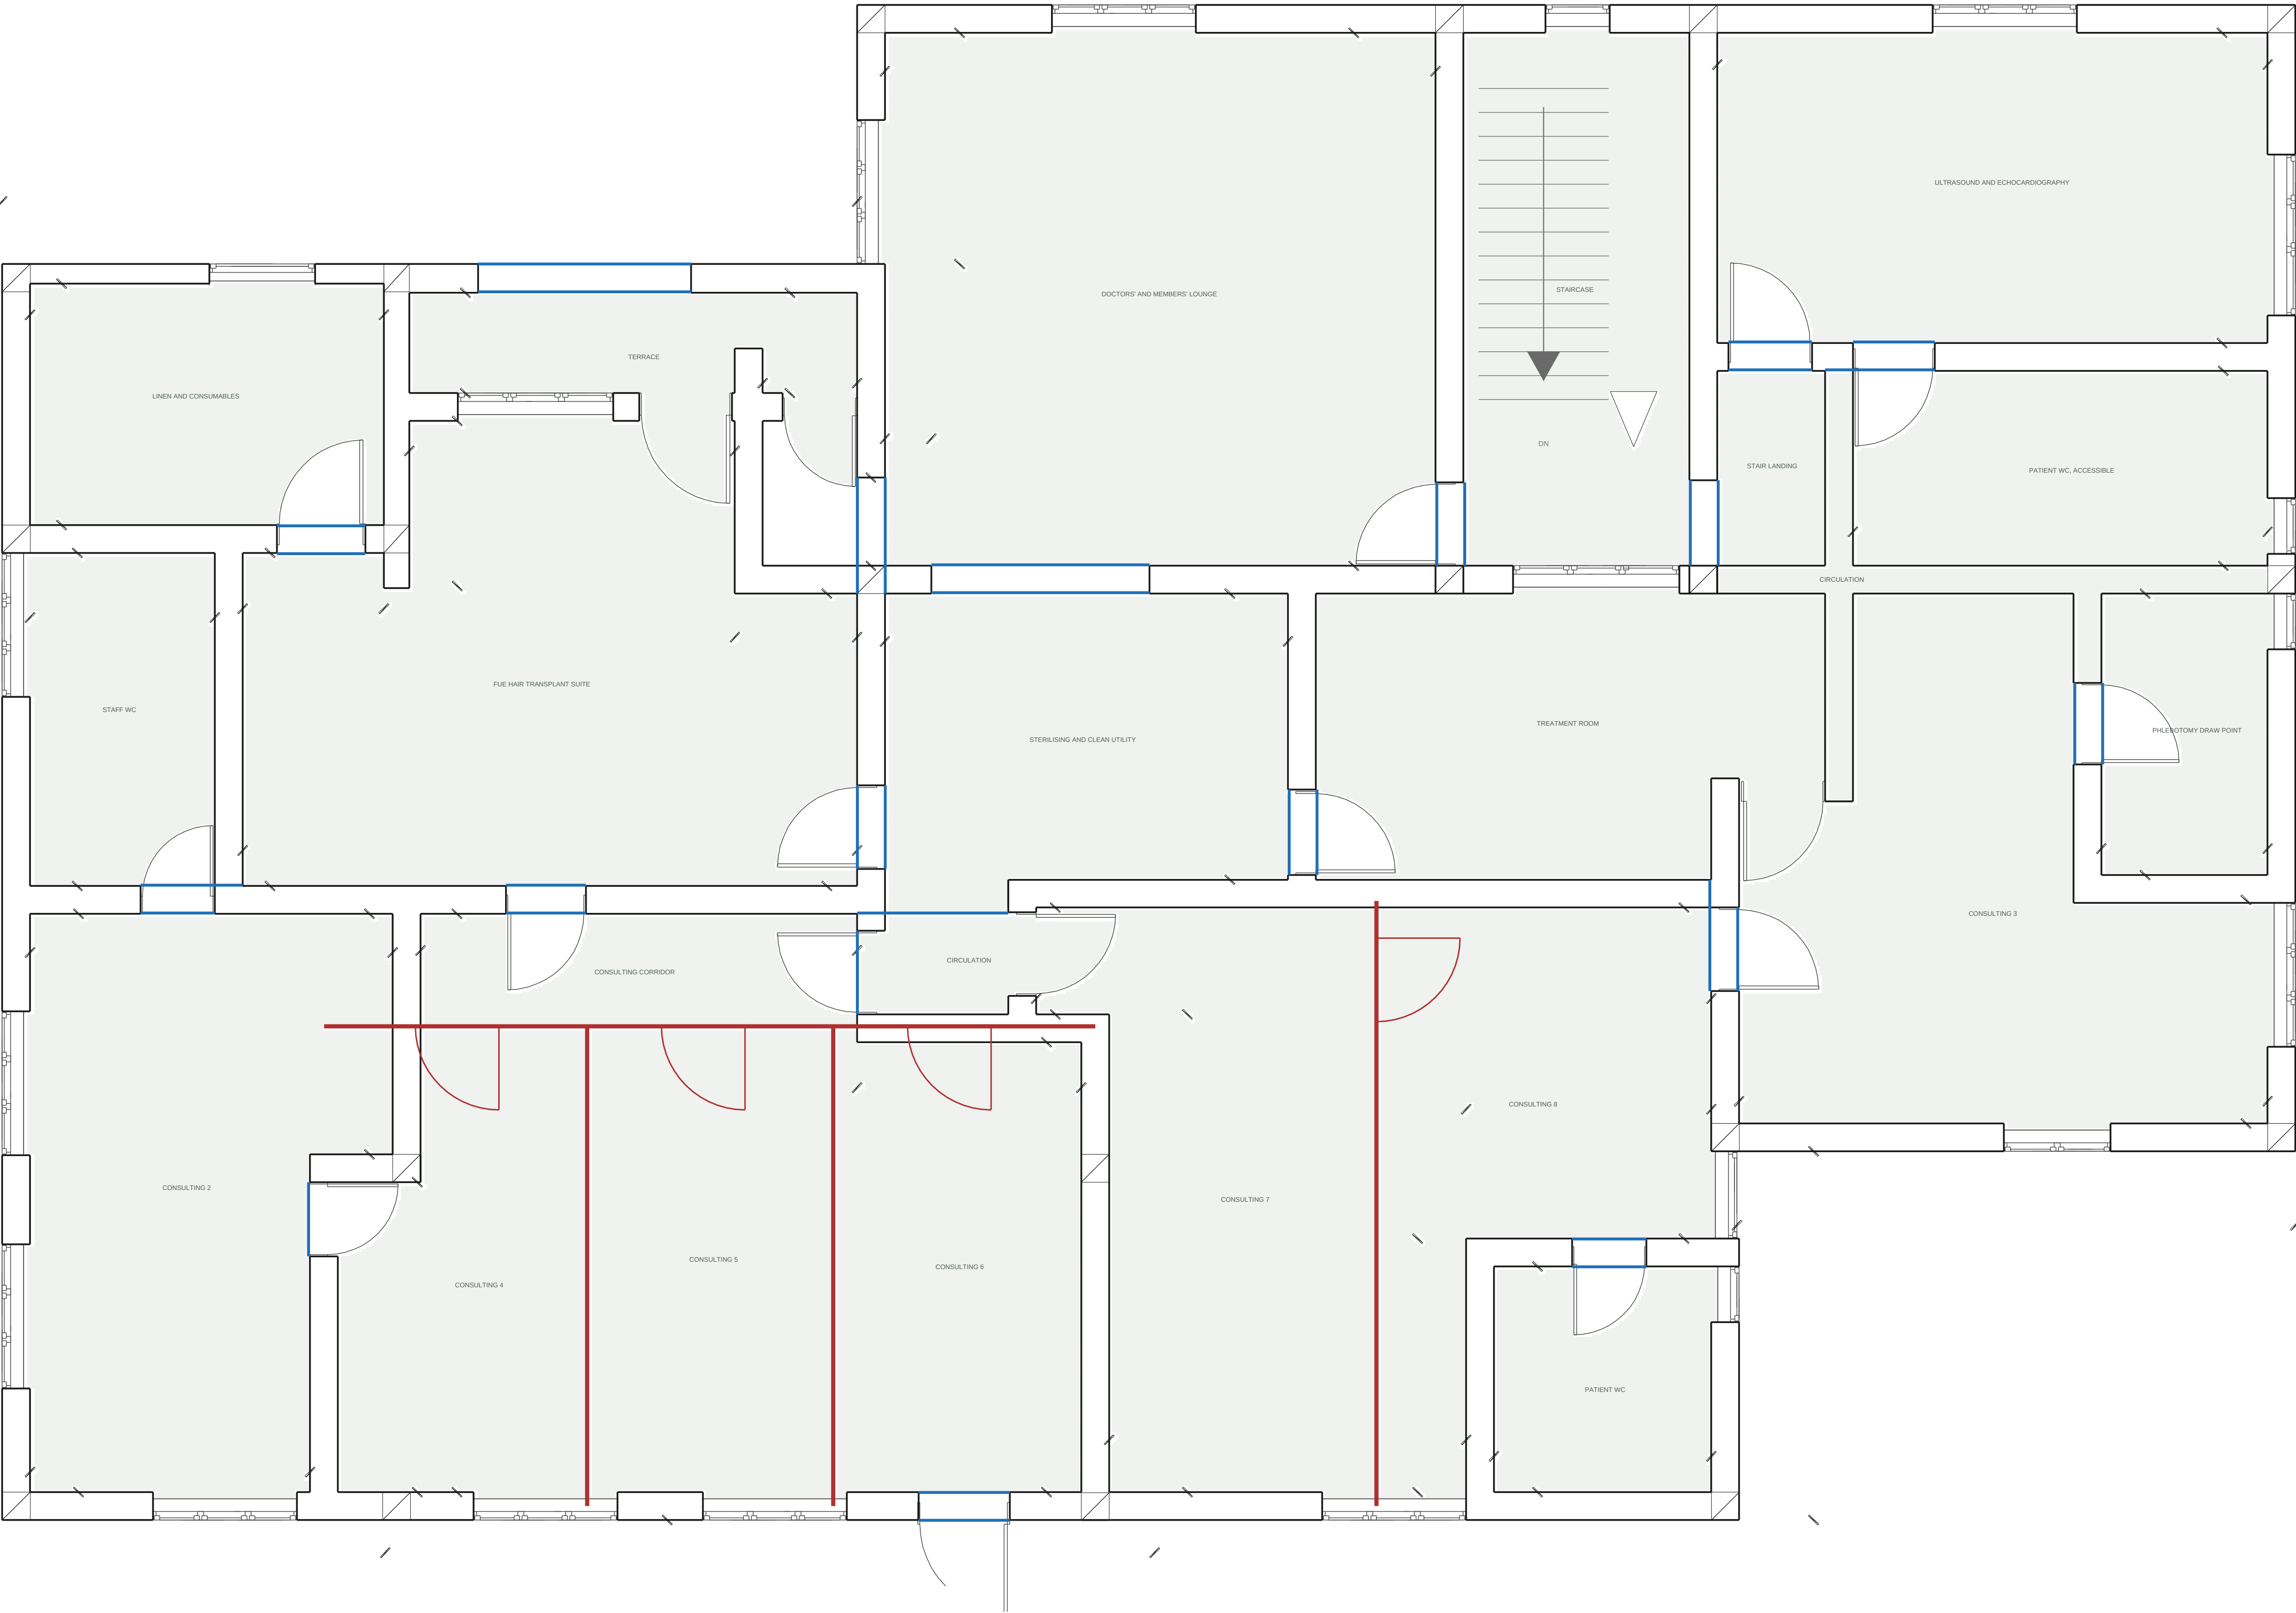

KEY

Existing wall, retained

New partition

Existing cased opening, no door today

Existing door swing or window, surveyed position

COUNTS, THIS FLOOR

Existing door and window openings, surveyed	39
Existing cased openings with no door	35
New partitions	4
New internal door openings	4
New openings in external walls	0
Rooms in the target state	23

- Four new partitions form five rooms out of two. Nothing structural is touched.

- The consulting spine is 1,200 mm clear. Three rooms hang off it at about 13 sqm each. Two rooms of 18 sqm would be more comfortable and would take the plaza from eight consulting rooms to seven. That is a commercial call, not a technical one.

- No sedation on this floor at any budget. There is no lift, and a sedated patient must be evacuated horizontally.

