


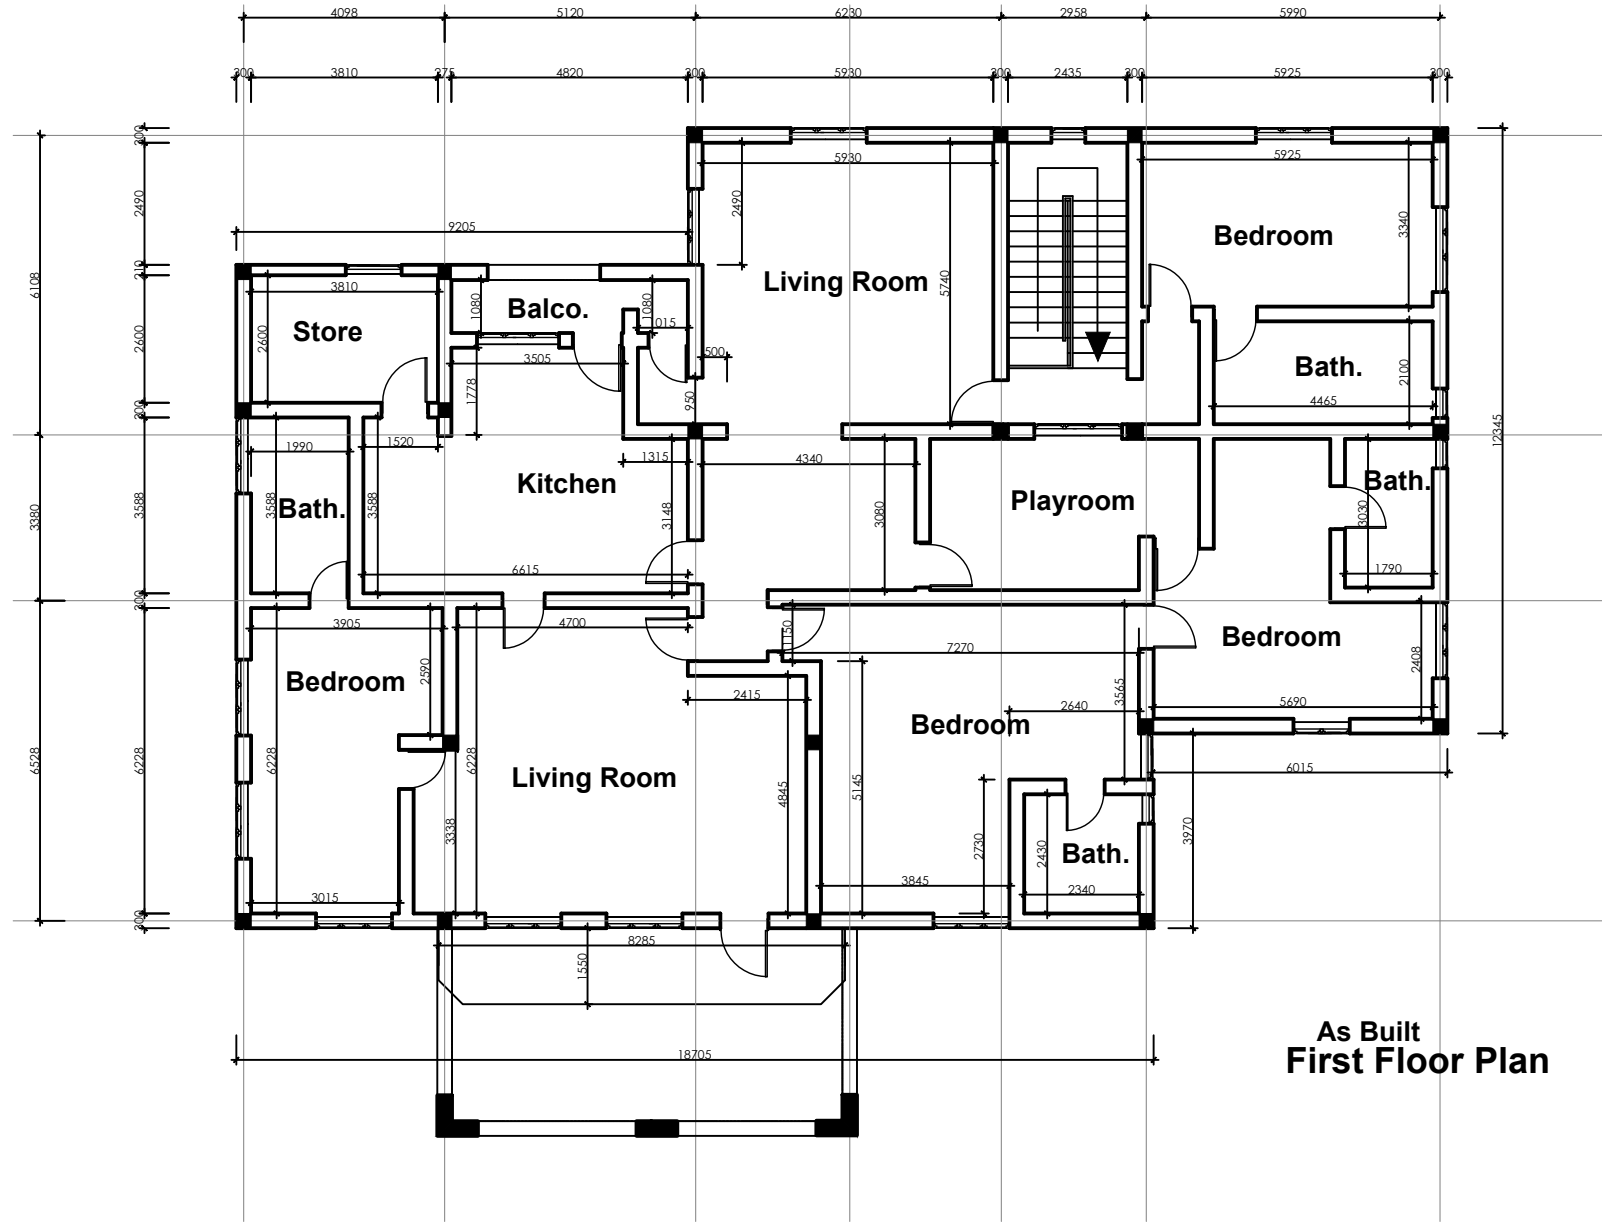

As Built
First Floor Plan